

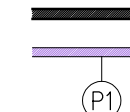
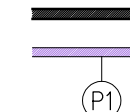
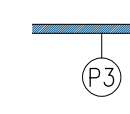


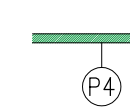


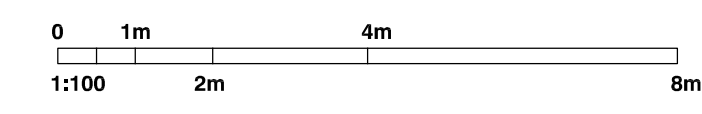
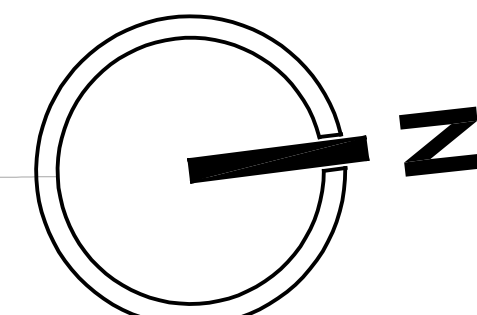


- PARTITIONS KEY:**
-  EXISTING PARTITION
 -  PARTITION TYPE P1: - 12 m
SOLID PARTITION CONSTRUCTED FROM SLAB TO SLAB
75mm STUD PARTITION CONSISTING OF 1 LAYER OF 12.5mm PLASTERBOARD TO EACH FACE OF 50mm C STUD WITH ACOUSTIC INSULATION.
(Rw 40dB)
 -  PARTITION TYPE P3: - 13 m
SOLID PARTITION CONSTRUCTED FROM SLAB TO SLAB
100mm STUD PARTITION CONSISTING OF 2 LAYERS OF 12.5mm WALL BOARD EACH SIDE OF 50mm C STUD AT 600mm CENTRES WITH 50mm INSULATION (APR1200 ACOUSTIC ROLL)
(Rw 45 dB)
 -  PARTITION TYPE P4: - 9 m
SOLID PARTITION CONSTRUCTED FROM SLAB TO SLAB
100mm STUD PARTITION CONSISTING OF 2 LAYERS OF 15mm DENSE BOARD EACH SIDE OF 50mm C STUD AT 600mm CENTRES WITH 50mm INSULATION (APR1200 ACOUSTIC ROLL)
(DnTw 47 dB)
 -  PARTITION TYPE P5: - 5 m
SAFE ROOMS
SOLID PARTITION CONSTRUCTED FROM SLAB TO SLAB
100MM STUD PARTITION CONSISTING OF 2 LAYERS OF 12.5MM SOUNDBLOC TO EACH FACE OF 50mm C STUD (AT 300 CENTRES), WITH 12.5mm OF FULL HEIGHT PLYWOOD SECURELY FIXED IN BETWEEN STUDS TO OUTER FACE ONLY, WITH 50mm INSULATION (APR1200 ACOUSTIC ROLL)
- ALL DOORS 2040MM HIGH
-  NEW DOOR NO.
 -  NEW DOOR (FD30S)
30min FIRE RATED
 -  NEW DOOR
SOLID CORE 44mm DOOR WITH SEALS
(Rw 30 dB)
 -  NEW DOOR
SOLID CORE 44mm DOOR WITH FULL PERIMETER SEALS (Rw 35 dB)
 -  NEW DOOR to Safe rooms
SOLID CORE 54mm door (35dB) with Vision panel, security access and ironmongery to G4S specification
With full perimeter seals

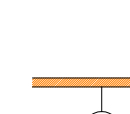

IOR

IMAGINATION TO CREATION

AB	As Built Issue	07.03.22	RC
P2	Drawing based on Implementation drawing 20-241 SK01-GD RevC	20.07.21	DC
P1	First Issue	06.07.21	DC
Revision	Revision description	Date	Drawn by / Checked by / Project Status

AS BUILT		
Dwg.	20-241 PP00	
Project	Spencer House 29 Grove Hill Road Harrow HA1 3BN	
Client	DWP	
Title	Ground Floor Proposed Partitions Plan	
Start Date	Drawn By	Revision
XX.XX.XX	DC	AB
Scale	Checked by	
1:100 @ A1	DC	

Instant
RETHINKING WORKSPACE

The Blue Fin Building,
110 Southwark Street,
London, SE1 0TA.

T: +44(0)20 7298 0611
www.theinstantgroup.com
www.instantoffices.com