


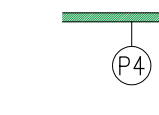

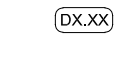

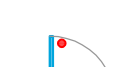


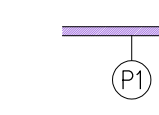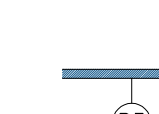


PARTITIONS KEY:

-  EXISTING PARTITION
-  PARTITION TYPE P1: - 25 m
SOLID PARTITION CONSTRUCTED FROM SLAB TO SLAB
75mm STUD PARTITION CONSISTING OF 1 LAYER OF 12.5mm PLASTERBOARD TO EACH FACE OF 50mm C STUD WITH ACOUSTIC INSULATION.
(Rw 40dB)
-  PARTITION TYPE P3: - 46 m
SOLID PARTITION CONSTRUCTED FROM SLAB TO SLAB
100mm STUD PARTITION CONSISTING OF 2 LAYERS OF 12.5mm WALL BOARD EACH SIDE OF 50mm C STUD AT 600mm CENTRES WITH 50mm INSULATION (APR1200 ACOUSTIC ROLL)
(Rw 45 dB)
-  PARTITION TYPE P4: - 26 m
SOLID PARTITION CONSTRUCTED FROM SLAB TO SLAB
100mm STUD PARTITION CONSISTING OF 2 LAYERS OF 15mm DENSE BOARD EACH SIDE OF 50mm C STUD AT 600mm CENTRES WITH 50mm INSULATION (APR1200 ACOUSTIC ROLL)
(DnTw 47 dB)
-  PARTITION TYPE P5: - 0 m
SOLID PARTITION CONSTRUCTED FROM SLAB TO SLAB
100MM STUD PARTITION CONSISTING OF 2 LAYERS OF 12.5MM SOUNDBLOC TO EACH FACE OF 50mm C STUD (AT 300 CENTRES), WITH 12.5mm OF FULL HEIGHT PLYWOOD SECURELY FIXED IN BETWEEN STUDS TO OUTER FACE ONLY, WITH 50mm INSULATION (APR1200 ACOUSTIC ROLL)

ALL DOORS 2040MM HIGH

-  NEW DOOR NO.
-  NEW DOOR (FD30S)
30min FIRE RATED
-  NEW DOOR
SOLID CORE 44mm DOOR WITH SEALS
(Rw 30 dB)
-  NEW DOOR
SOLID CORE 44mm DOOR WITH FULL PERIMETER SEALS (Rw 35 dB)
-  NEW DOOR to Safe rooms
SOLID CORE 54mm door (35dB) with Vision panel, security access and ironmongery to G4S specification
With full perimeter seals


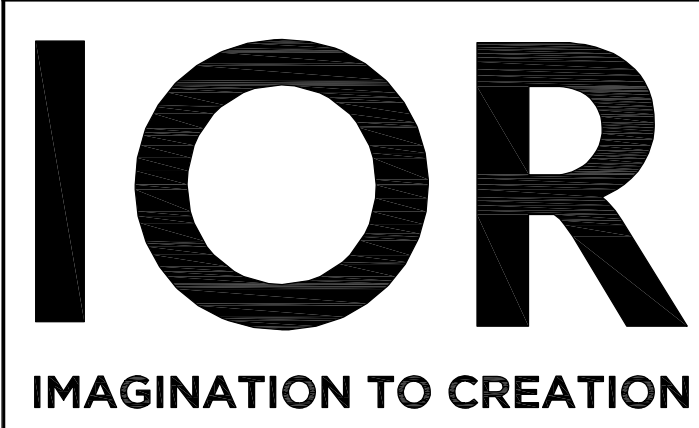


| Revision | Revision description | Date | Drawn by | Checked by | Project Status |
|----------|---|----------|----------|------------|----------------|
| AB | As Built Issue | 07.03.21 | DC | RG | |
| P3 | Former fallow space to be fit out | 26.08.21 | DC | DC | |
| P2 | Drawing based on Implementation drawing 20-241 SK01-03 RevC | 20.07.21 | DC | DC | |
| P1 | First Issue | 06.07.21 | DC | DC | |

AS BUILT

| | | |
|---------|---|--|
| Dwg. | 20-241 PP03 | |
| Project | Spencer House 29 Grove Hill Road Harrow HA1 3BN | |
| Client | DWP | |
| Title | Third Floor Proposed Partitions Plan | |

| | | |
|------------|------------|----------|
| Start Date | Drawn By | Revision |
| XX.XX.XX | DC | AB |
| Scale | Checked by | |
| 1:100 @ A1 | DC | |

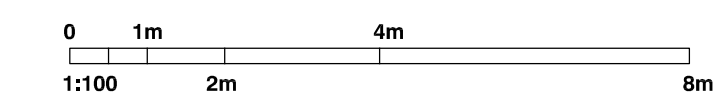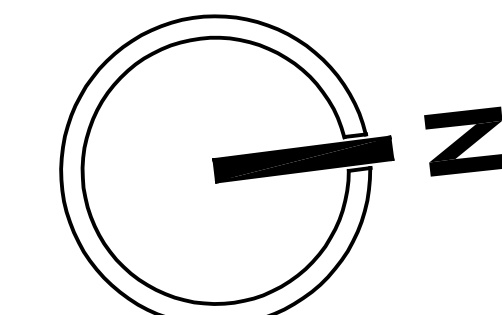

Instant
RETHINKING WORKSPACE

The Blue Fin Building,
110 Southwark Street,
London, SE1 0TA.

T: +44(0)20 7298 0611
www.theinstantgroup.com
www.instantoffices.com