


Third Floor

LH0448-M-03 MARGARET STREET

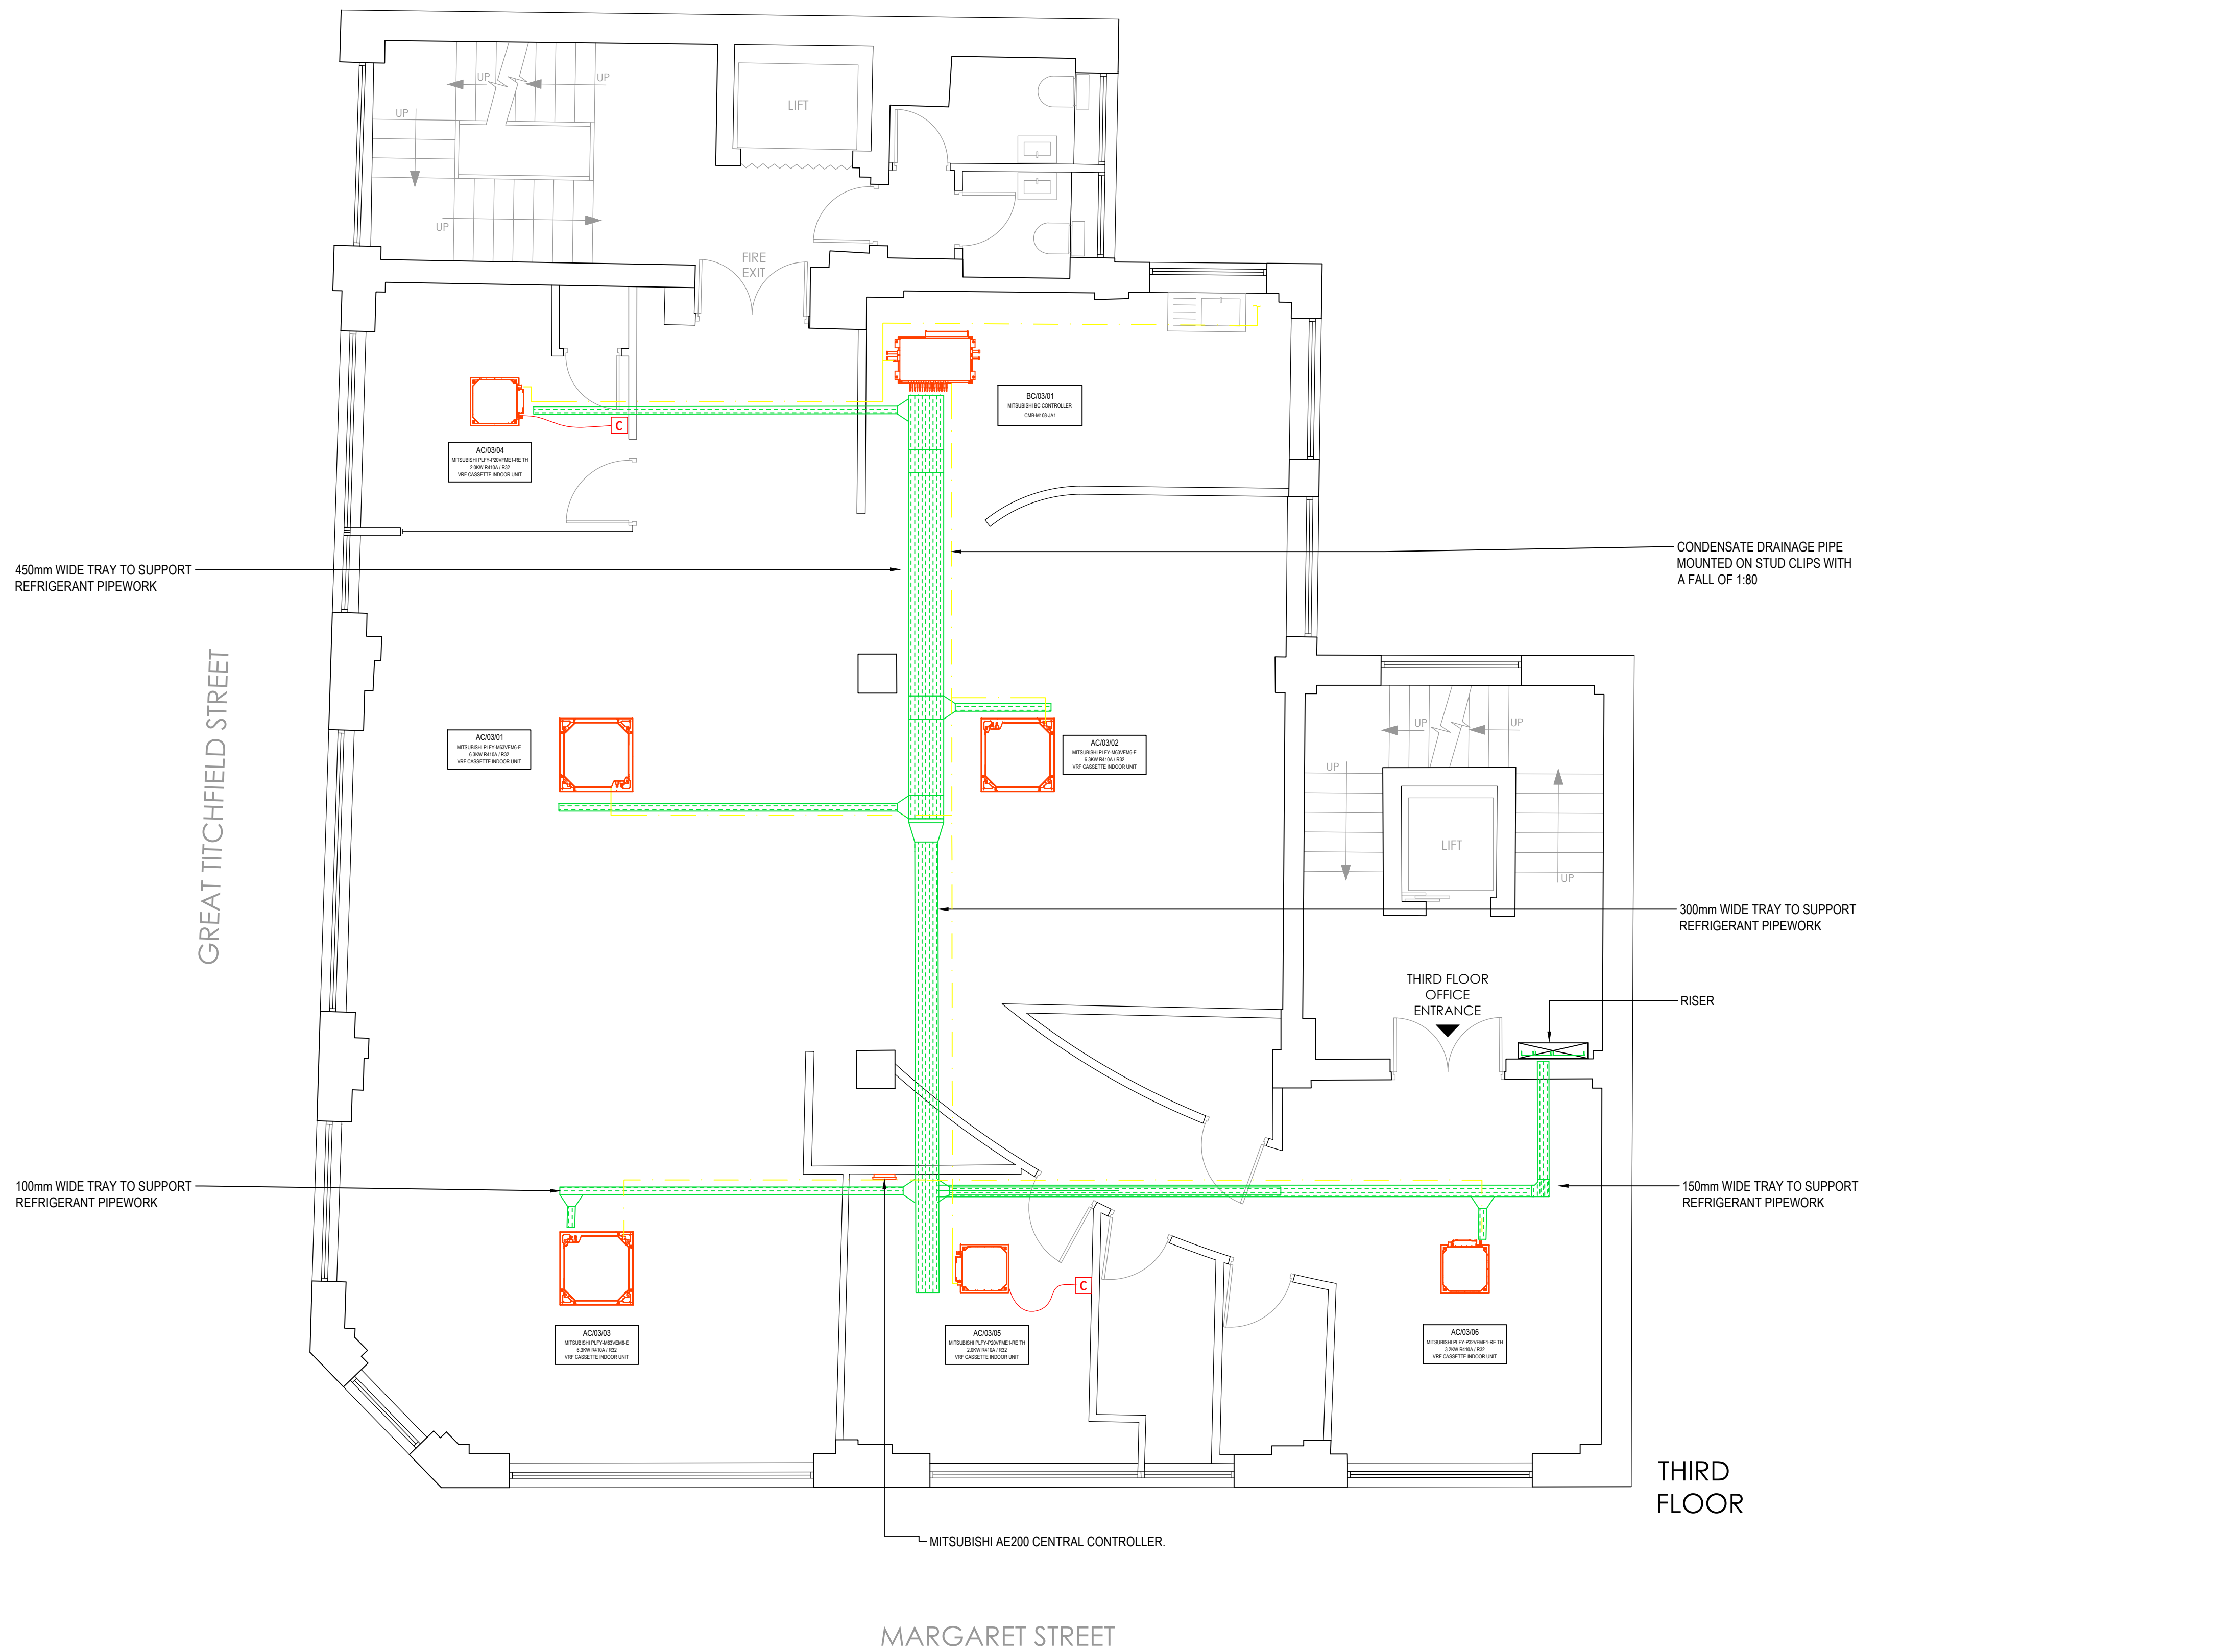

NOTES

Rev	Date	Description

Drawing Status: RECORD DRAWING



AIR CONDITIONING AND VENTILATION
WALTON BUSINESS CENTRE
44-46 TERRACE ROAD
WALTON ON THAMES
SURREY
KT12 2SD
T 01932 225439
T 0207 183 2569
F 0203 137 2336
www.atmospheresuk.com

Client: ROOTS CONTRACTORS

Project: 66-68 MARGARET STREET
LONDON

Title: 3RD FLOOR AIR CONDITIONING

Scale: 1 : 50 @ A1	Date: 13.03.2023
Drawn by: BDTS	
Checked/Approved by: MB	
Drawing Number: LH0448-M-03	Revision: R3